
竣工図
竣工 2026年11月30日

排水設備 竣工縦断図

（標準（下水道協会方式を参考））

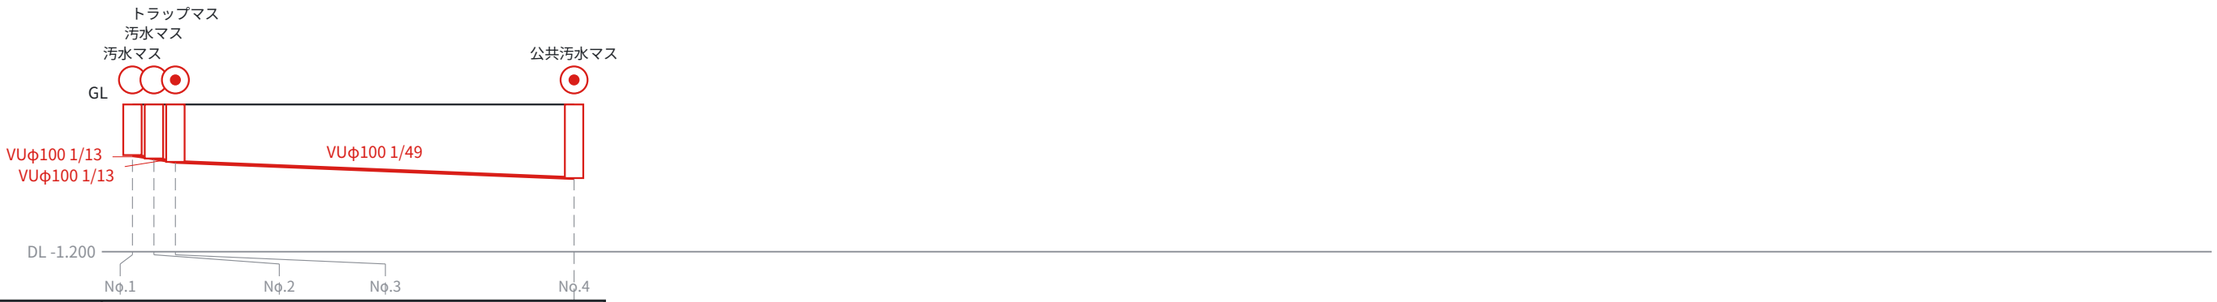

累加距離(m)	0.000	0.350	0.700	7.200
距離(m)	0.350	0.350	6.500	
勾配	1/13	1/13	1/49	
管種・口径	VUφ100	VUφ100	VUφ100	
地盤高(m)	0.000	0.000	0.000	0.000
管底高(m)	-0.413	-0.440	-0.468	-0.600
土被り(m)	0.299	0.326	0.354	0.486
マス	汚水マス φ300 深0.413	汚水マス φ300 深0.440	トラップマス φ300 深0.468	公共汚水マス φ300 深0.600

凡例: 赤＝新設・増設　青＝既設　黒＝公共下水道　橙＝警告

工事名	竣工テスト
申請者	
施工者	
図面名	排水設備 竣工縦断図
縮尺	H 1/100 V 1/50
作成日	2026年11月12日

本図は作図支援ツール（PipeCraft 3D）の出力です。自治体の審査基準への適合を保証しません。